2484 Brentwood

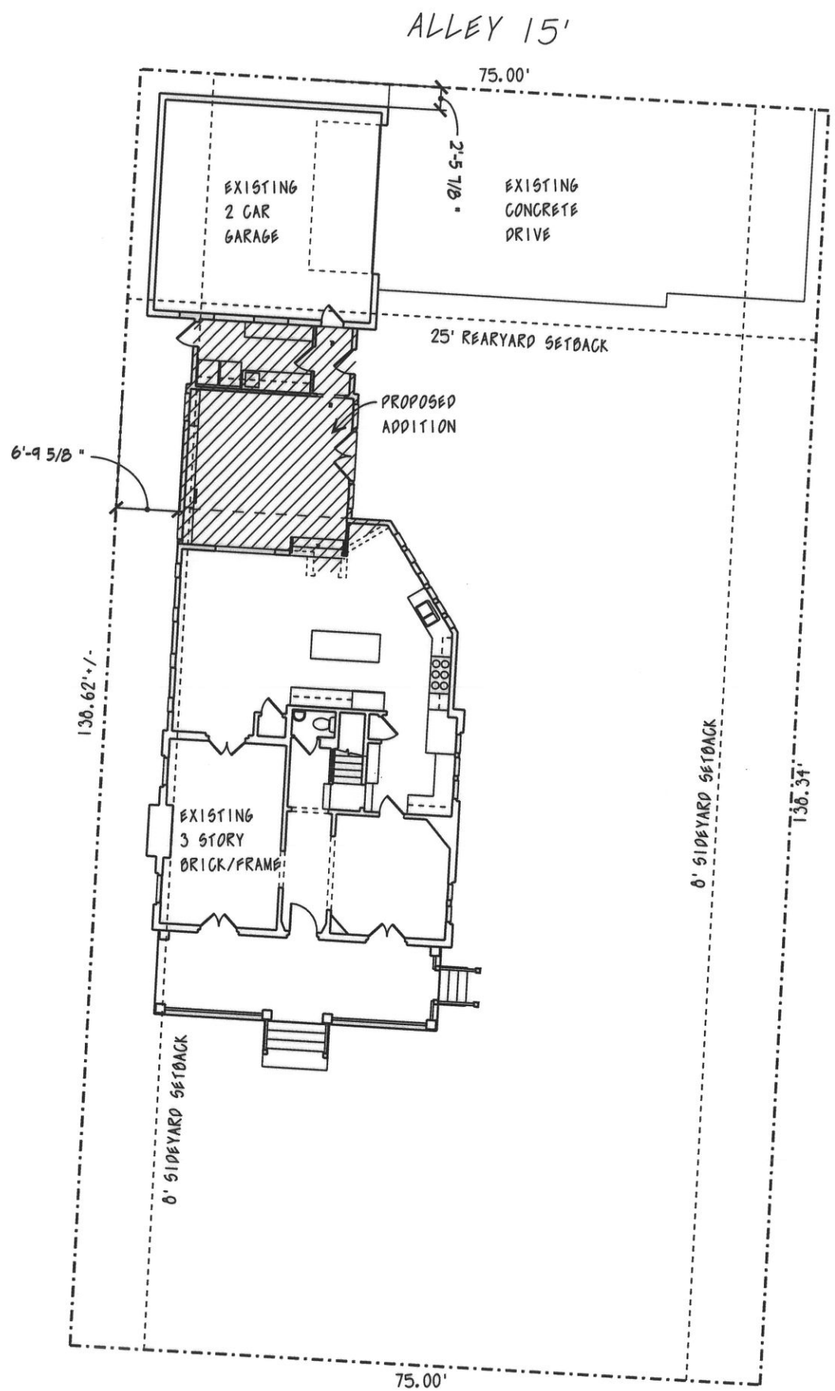

PROPOSED SITE PLAN

BRENTWOOD ROAD 60'

SCALE: 1/16" = 1'-0"

NORTH

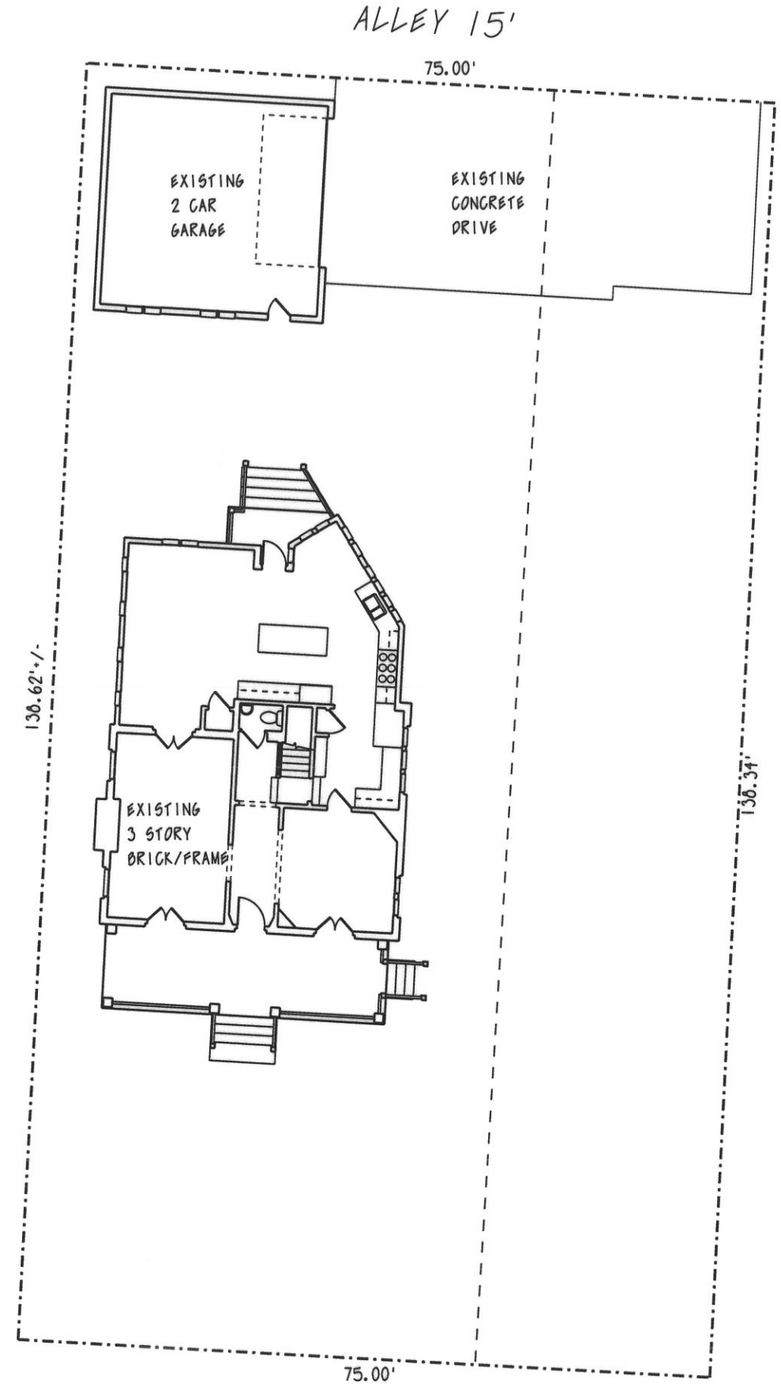

ASBUILT SITE PLAN

BRENTWOOD ROAD 60'

SCALE: 1/16" = 1'-0"

NORTH

JULIET BULLOCK ARCHITECTS
1182 WYANDOTTE RD
COLUMBUS OH 43212
614-935-0944

INDEX TO DRAWINGS

SHEET 1 SITE PLANS

SHEET 2 ASBUILT FIRST FLOOR PLAN & ASBUILT SECOND FLOOR PLAN

SHEET 3 PROPOSED FIRST FLOOR PLAN

SHEET 4 PROPOSED SECOND FLOOR PLAN

SHEET 5 EXTERIOR ELEVATIONS

SHEET 6 EXTERIOR ELEVATIONS

ZONING INFORMATION

ZONED R-6
LOT AREA 10,395 SF
HOUSE FOOT PRINT 2406 SF

BUILDING CODE INFO

CONSTRUCT A ONE AND TWO STORY ADDITION TO THE REAR OF THE HOME.

11/26/14

HICKS RESIDENCE
2484 BRENTWOOD ROAD
COLUMBUS OHIO

SHEET 1

JULIET BULLOCK ARCHITECTS
1182 WYANDOTTE RD
COLUMBUS OH 43212
614-935-0944

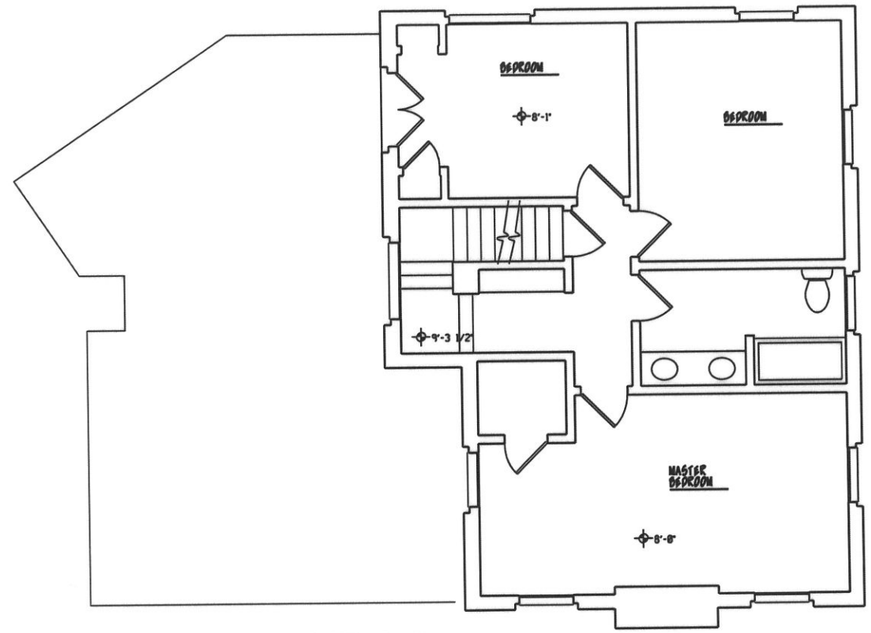

ASBUILT
SECOND FLOOR PLAN

SCALE: 1/8" = 1'-0"

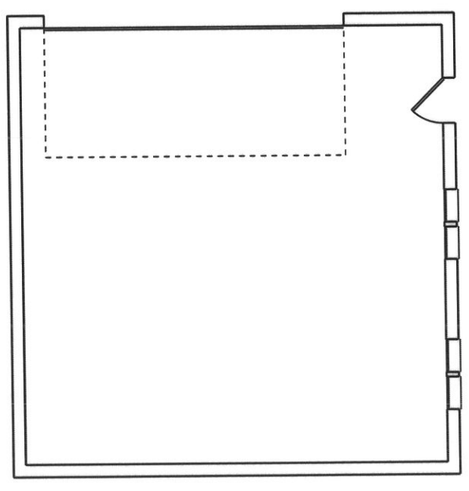

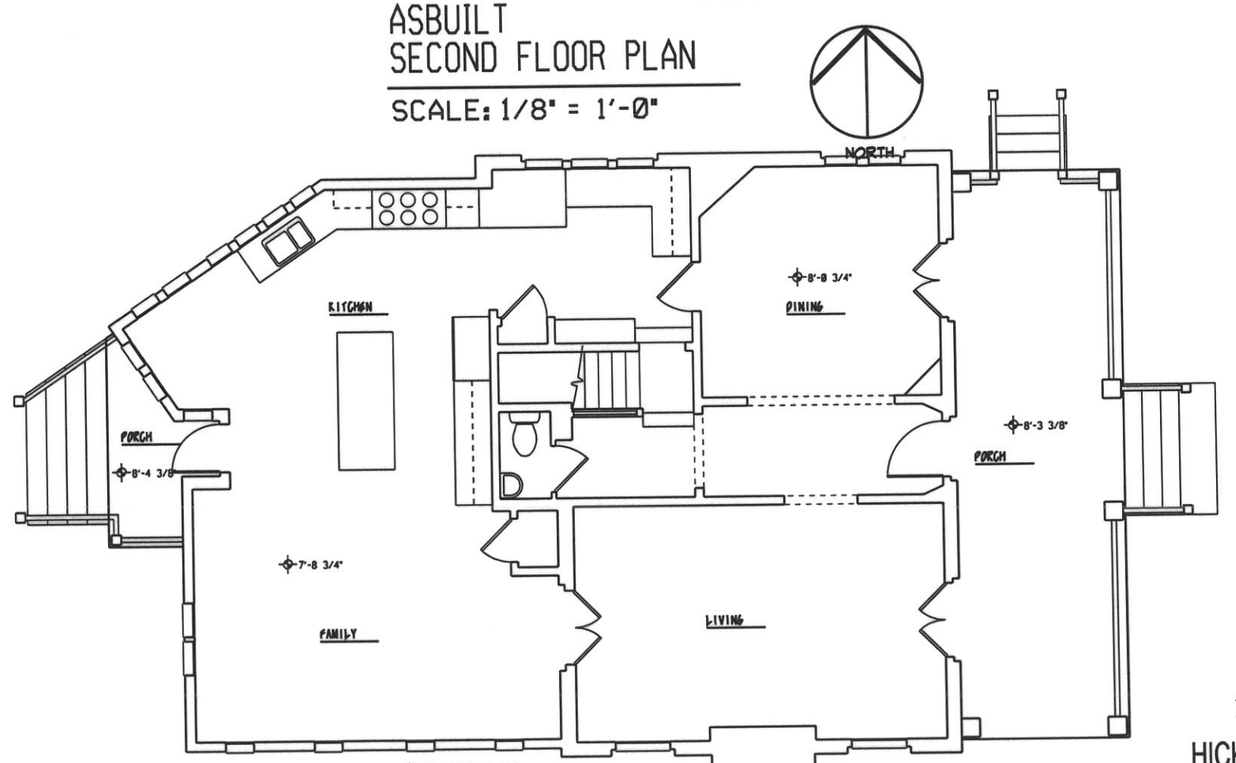

ASBUILT
FIRST FLOOR PLAN

SCALE: 1/8" = 1'-0"

NORTH

11/26/14

HICKS RESIDENCE
2484 BRENTWOOD ROAD
COLUMBUS OHIO

SHEET 2

JULIET BULLOCK ARCHITECTS
1182 WYANDOTTE RD
COLUMBUS OH 43212
614-935-0944

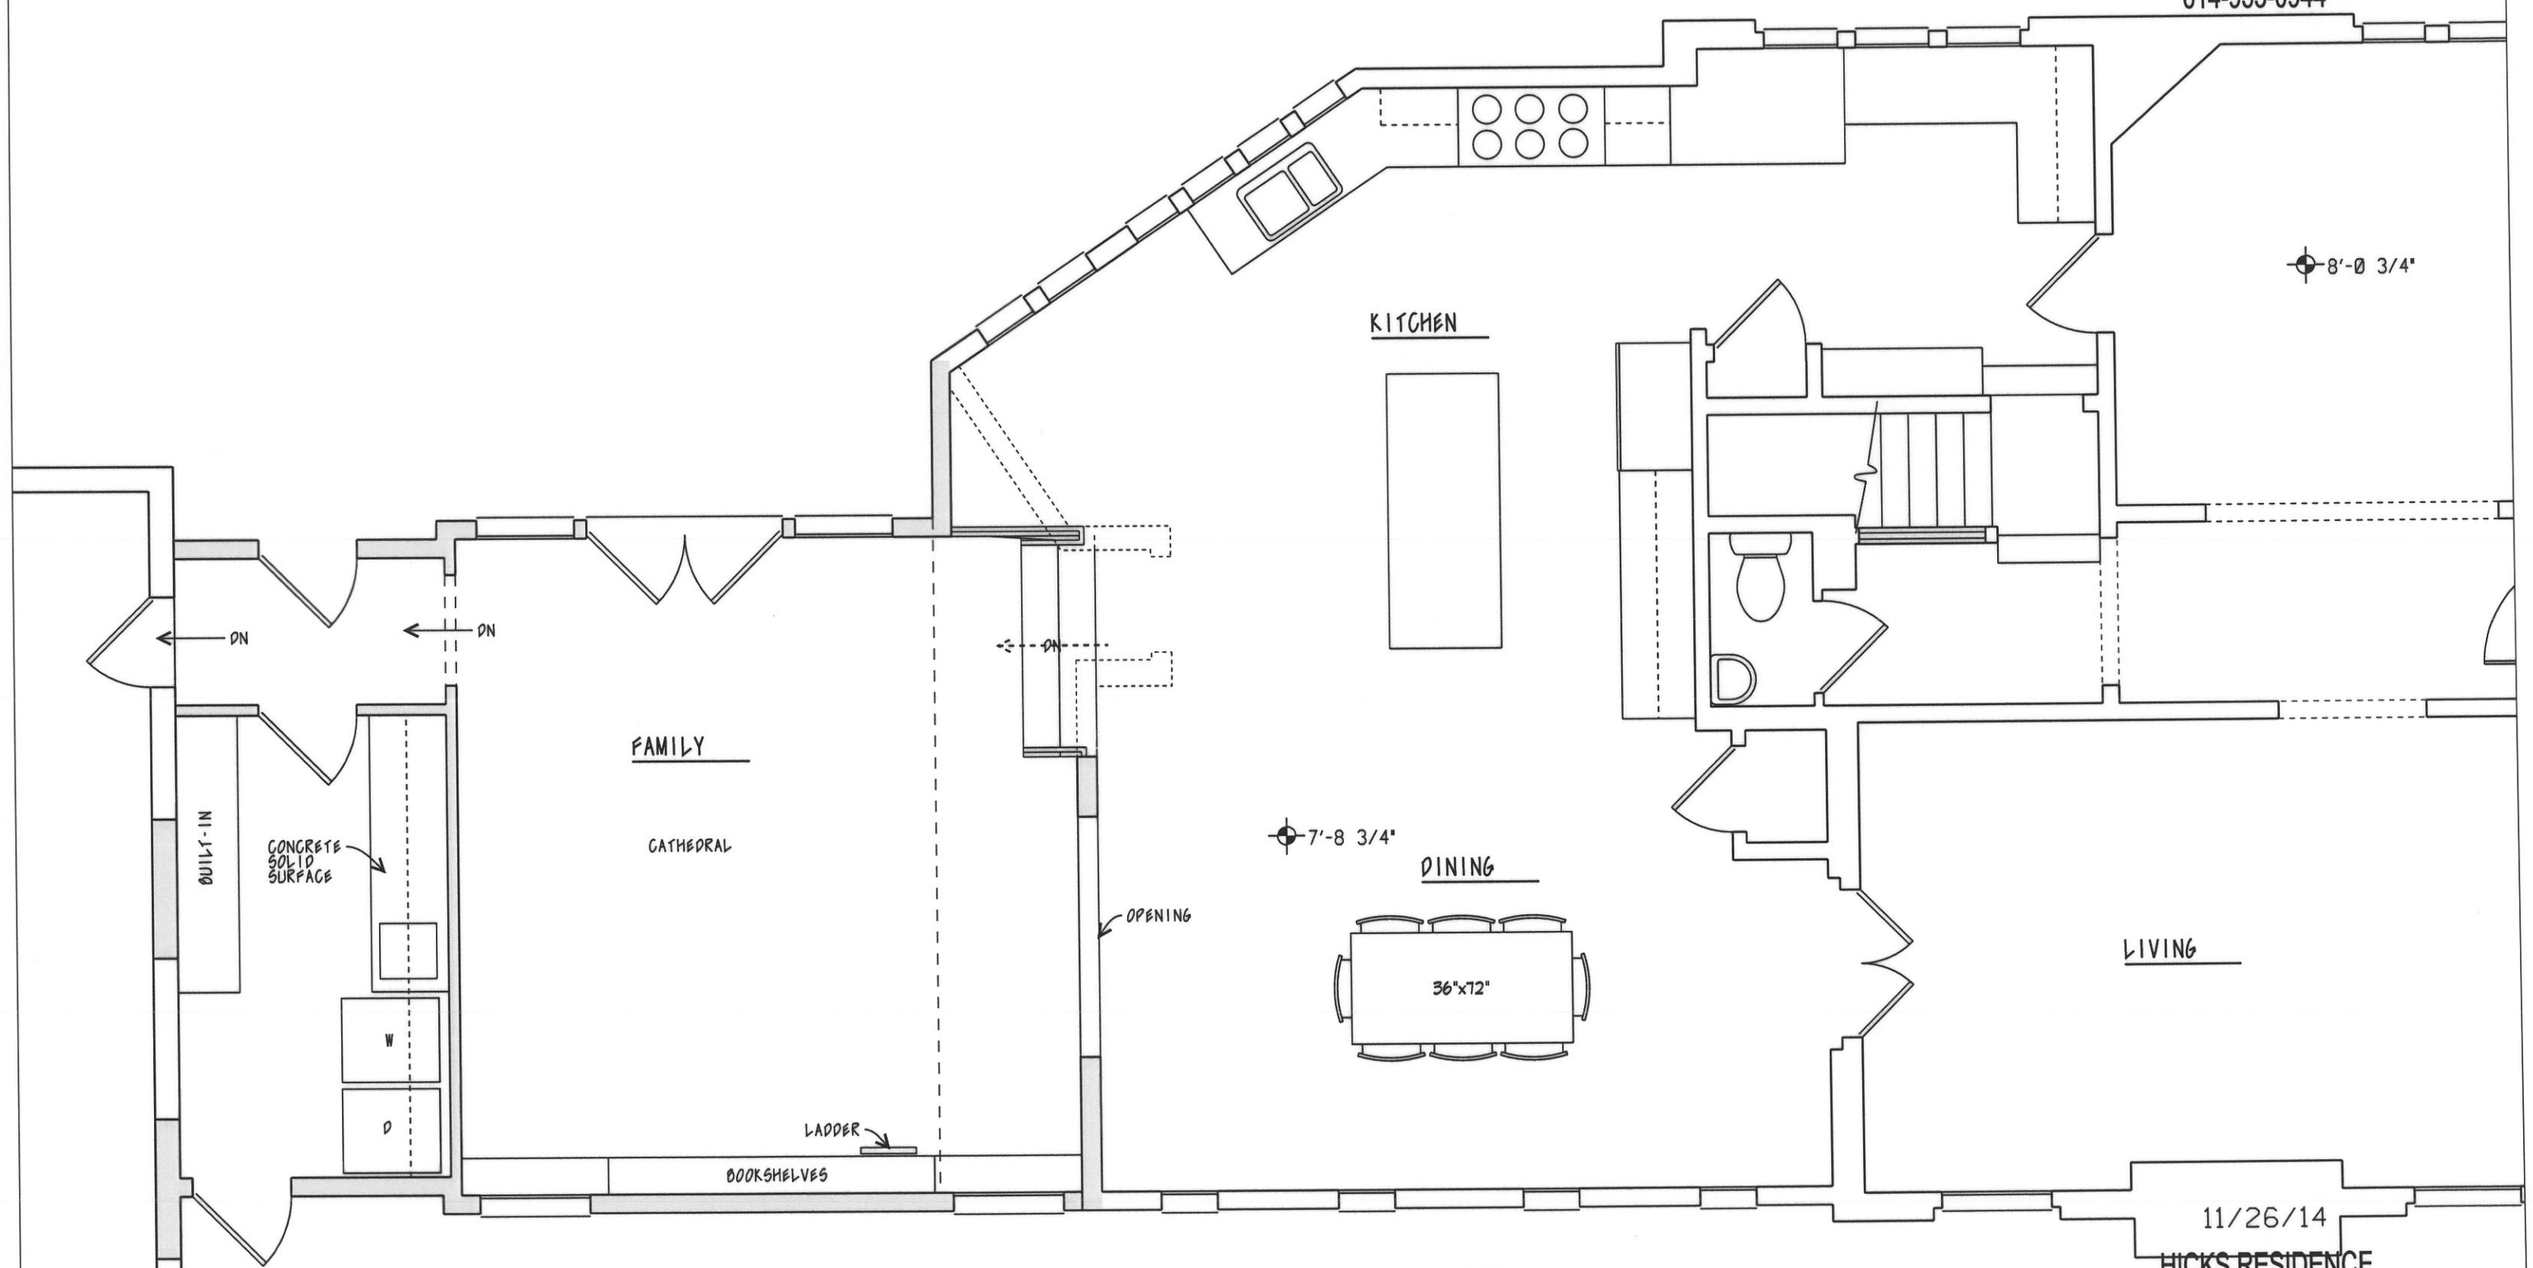

11/26/14

HICKS RESIDENCE
2484 BRENTWOOD ROAD
COLUMBUS OHIO

PROPOSED
FIRST FLOOR PLAN

SCALE: 1/4" = 1'-0"

NORTH

SHEET 3

JULIET BULLOCK ARCHITECTS
1182 WYANDOTTE RD
COLUMBUS OH 43212
614-935-0944

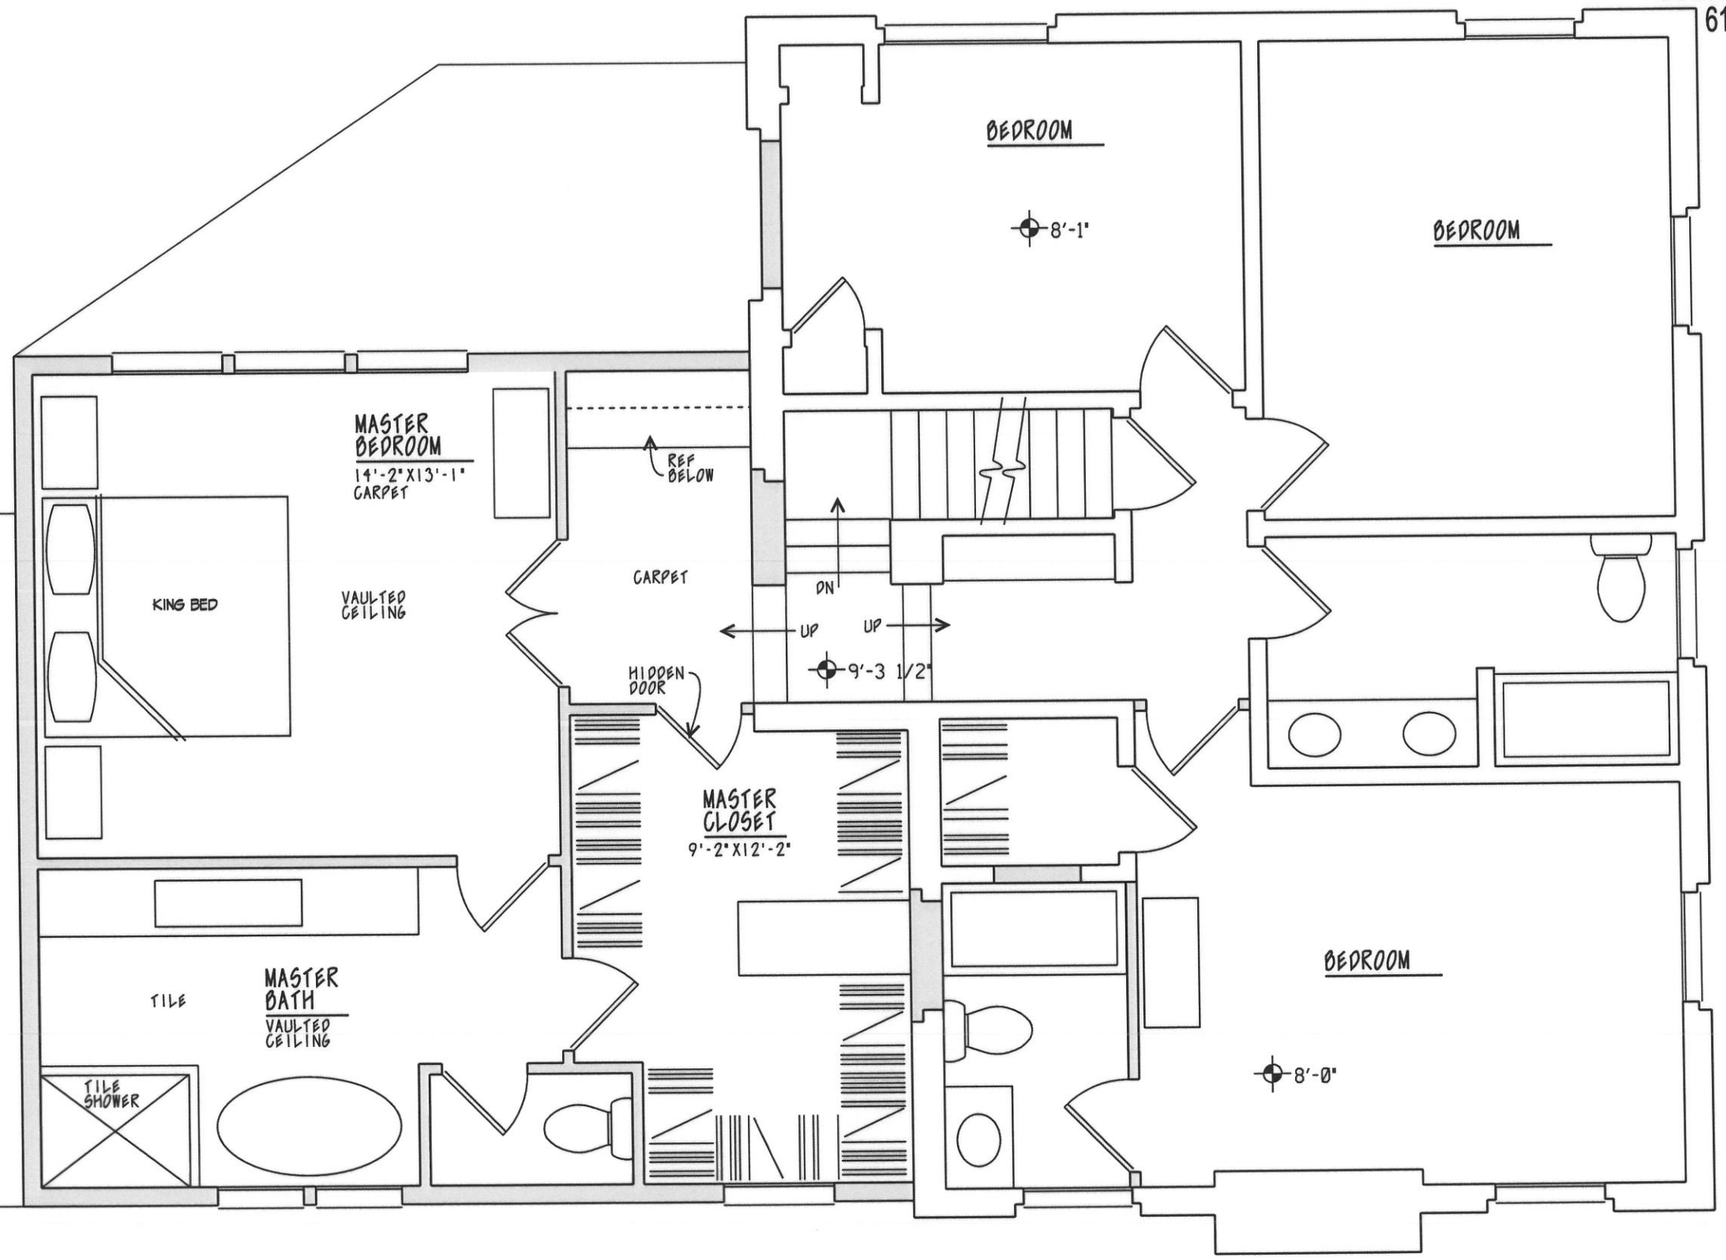

11/26/14

PROPOSED
SECOND FLOOR PLAN

SCALE: 1/4" = 1'-0"

NORTH

HICKS RESIDENCE
2484 BRENTWOOD ROAD
COLUMBUS OHIO

SHEET 3

JULIET BULLOCK ARCHITECTS
1182 WYANDOTTE RD
COLUMBUS OH 43212
614-935-0944

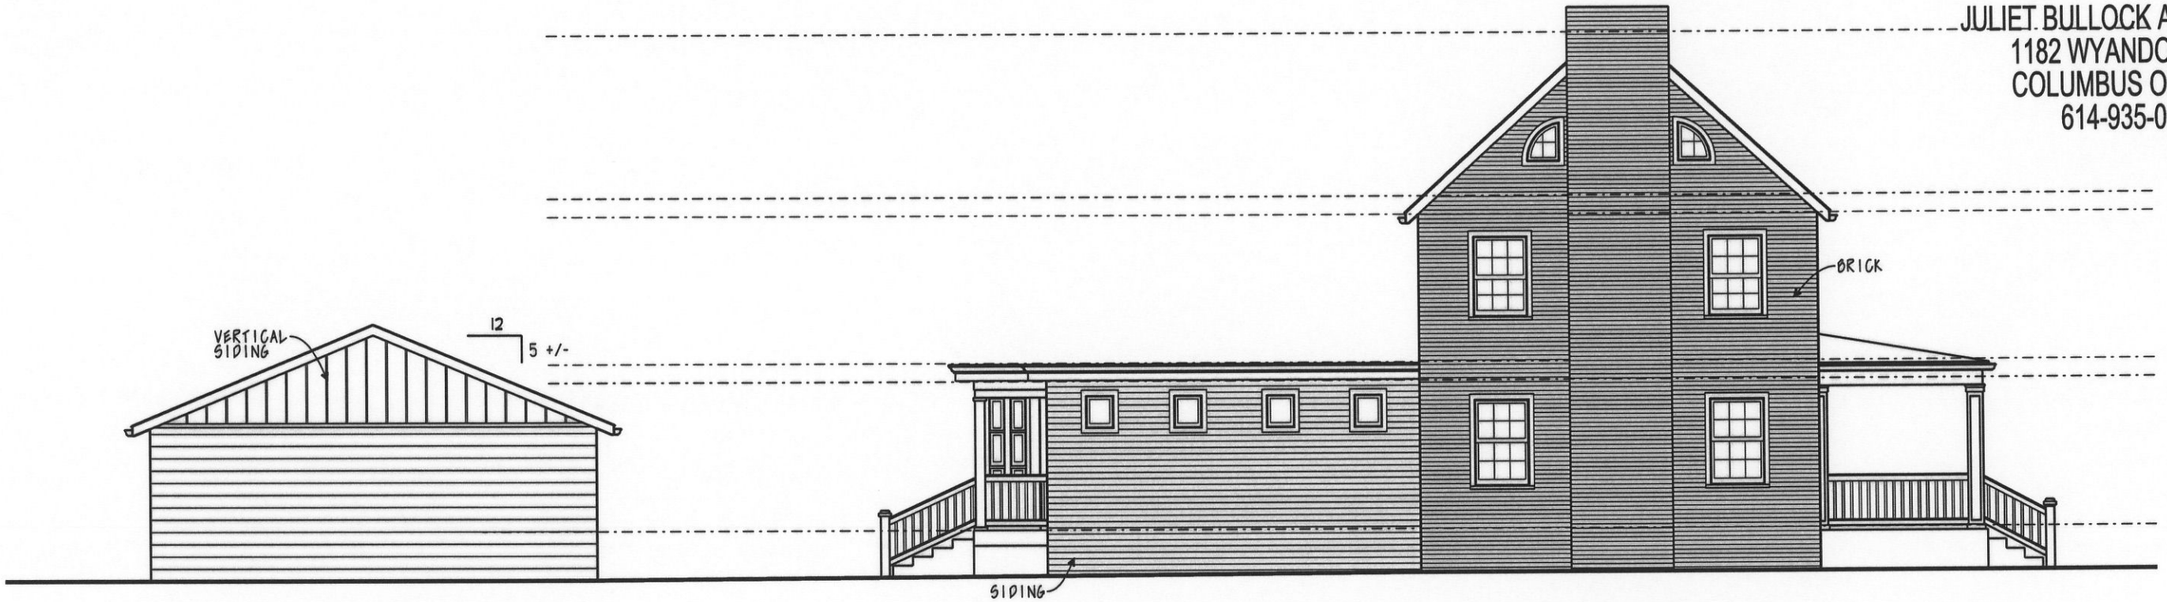

ASBUILT WEST ELEVATION

SCALE: 1/8" = 1'-0"

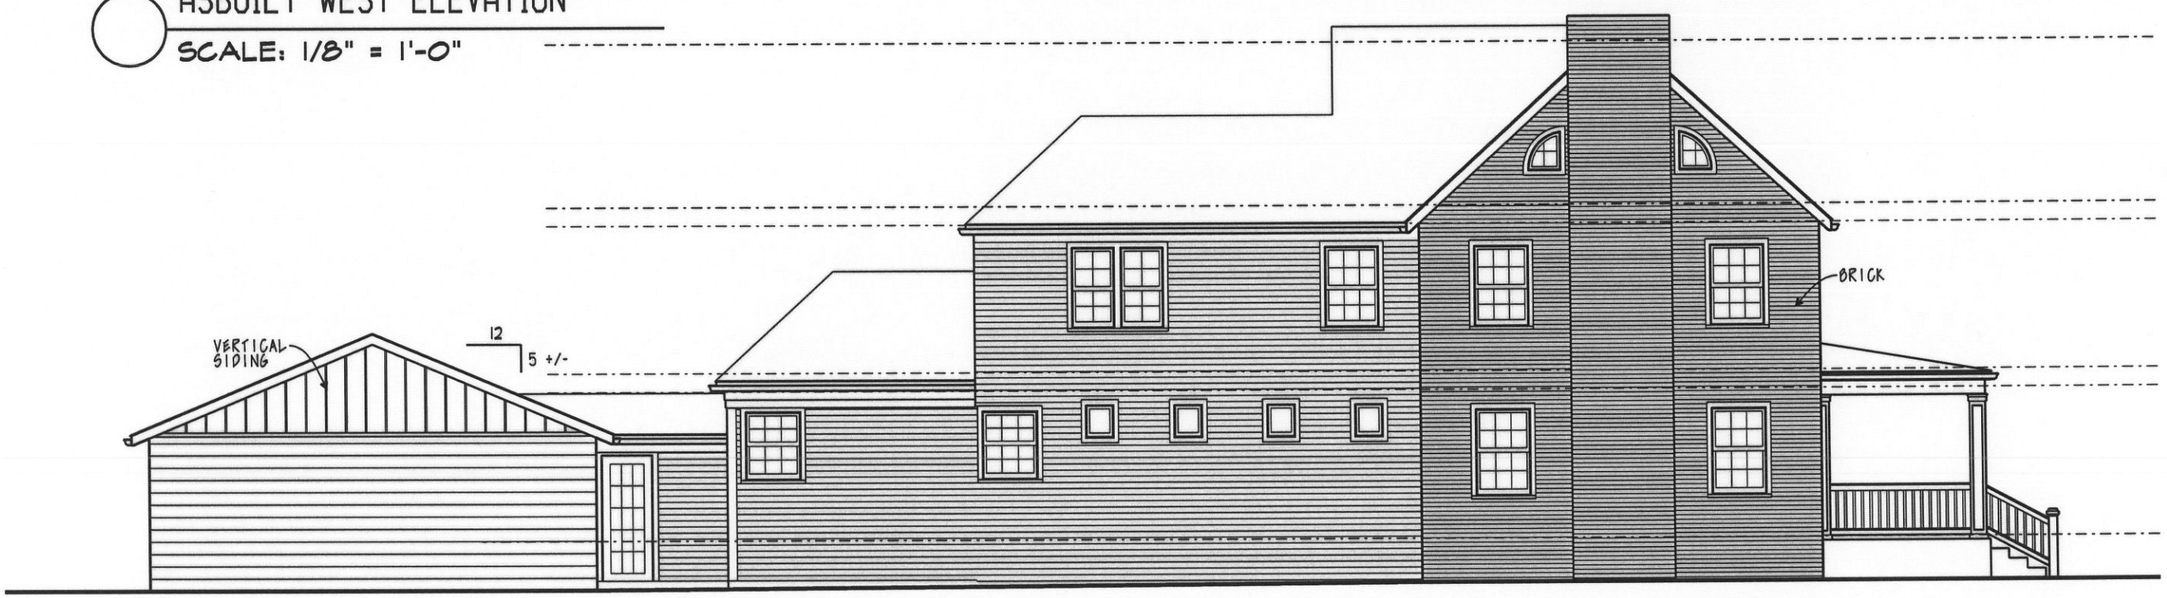

PROPOSED WEST ELEVATION

SCALE: 1/8" = 1'-0"

11/26/14

HICKS RESIDENCE
2484 BRENTWOOD ROAD
COLUMBUS OHIO

JULIET BULLOCK ARCHITECTS
1182 WYANDOTTE RD
COLUMBUS OH 43212
614-935-0944

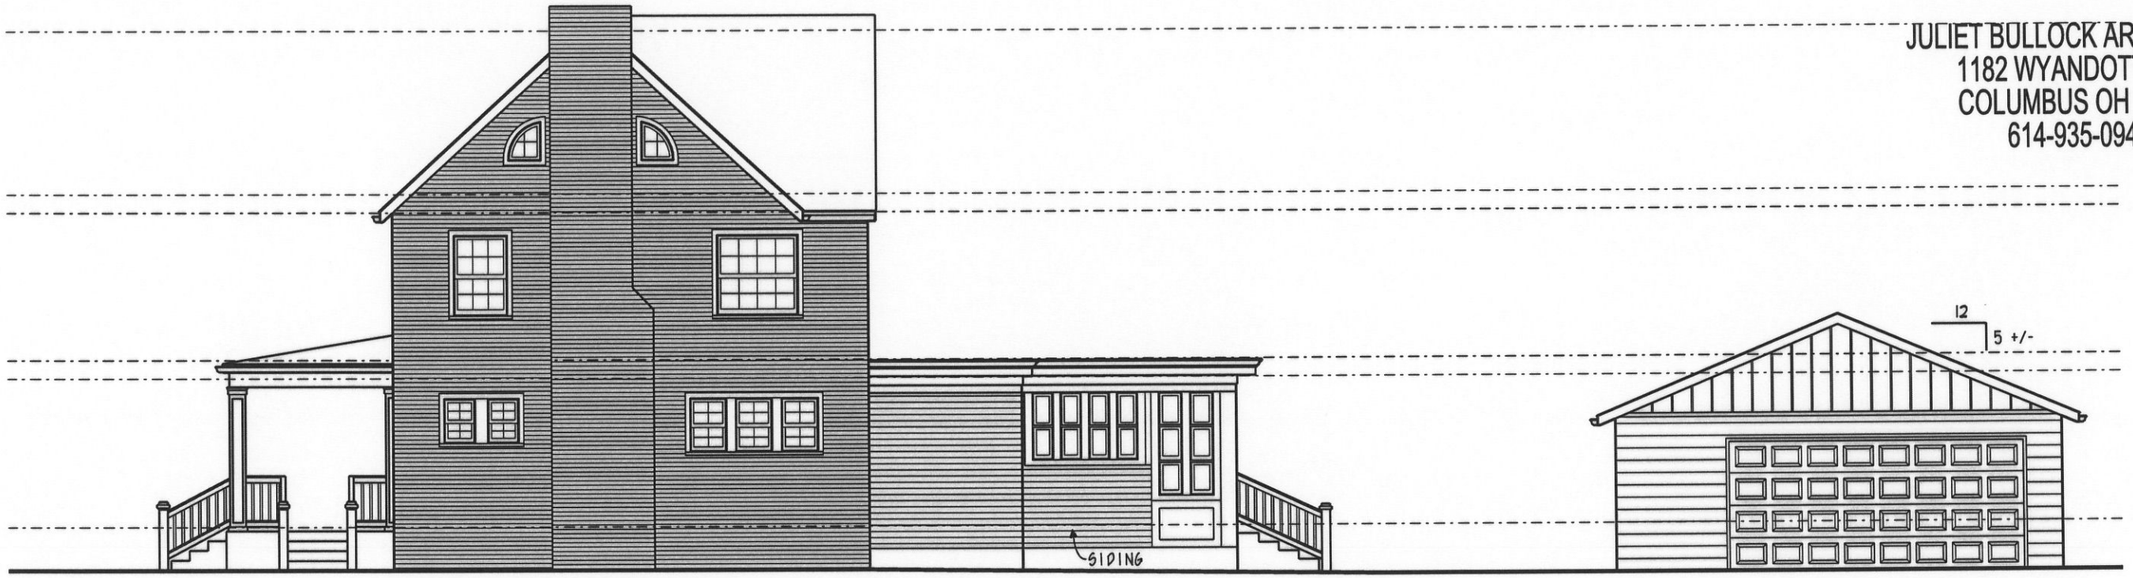

ASBUILT
EAST ELEVATION
SCALE: *" = 1'-0"

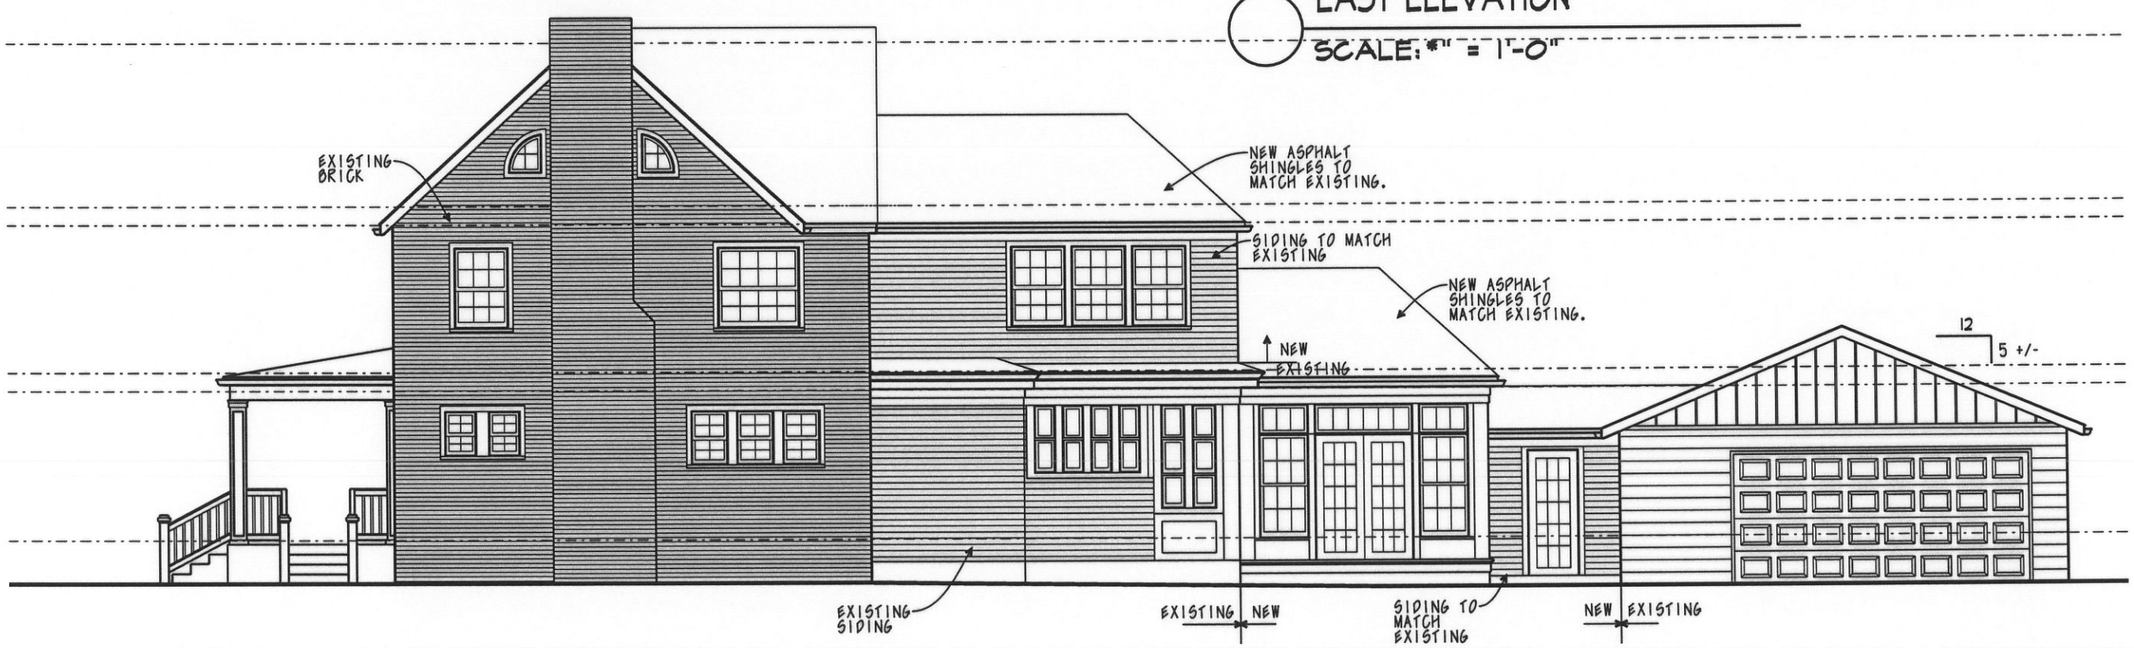

PROPOSED
EAST ELEVATION
SCALE: *" = 1'-0"

11/26/14

HICKS RESIDENCE
2484 BRENTWOOD ROAD
COLUMBUS OHIO